



HORNBY STREET

WEST HASTINGS STREET

LANE

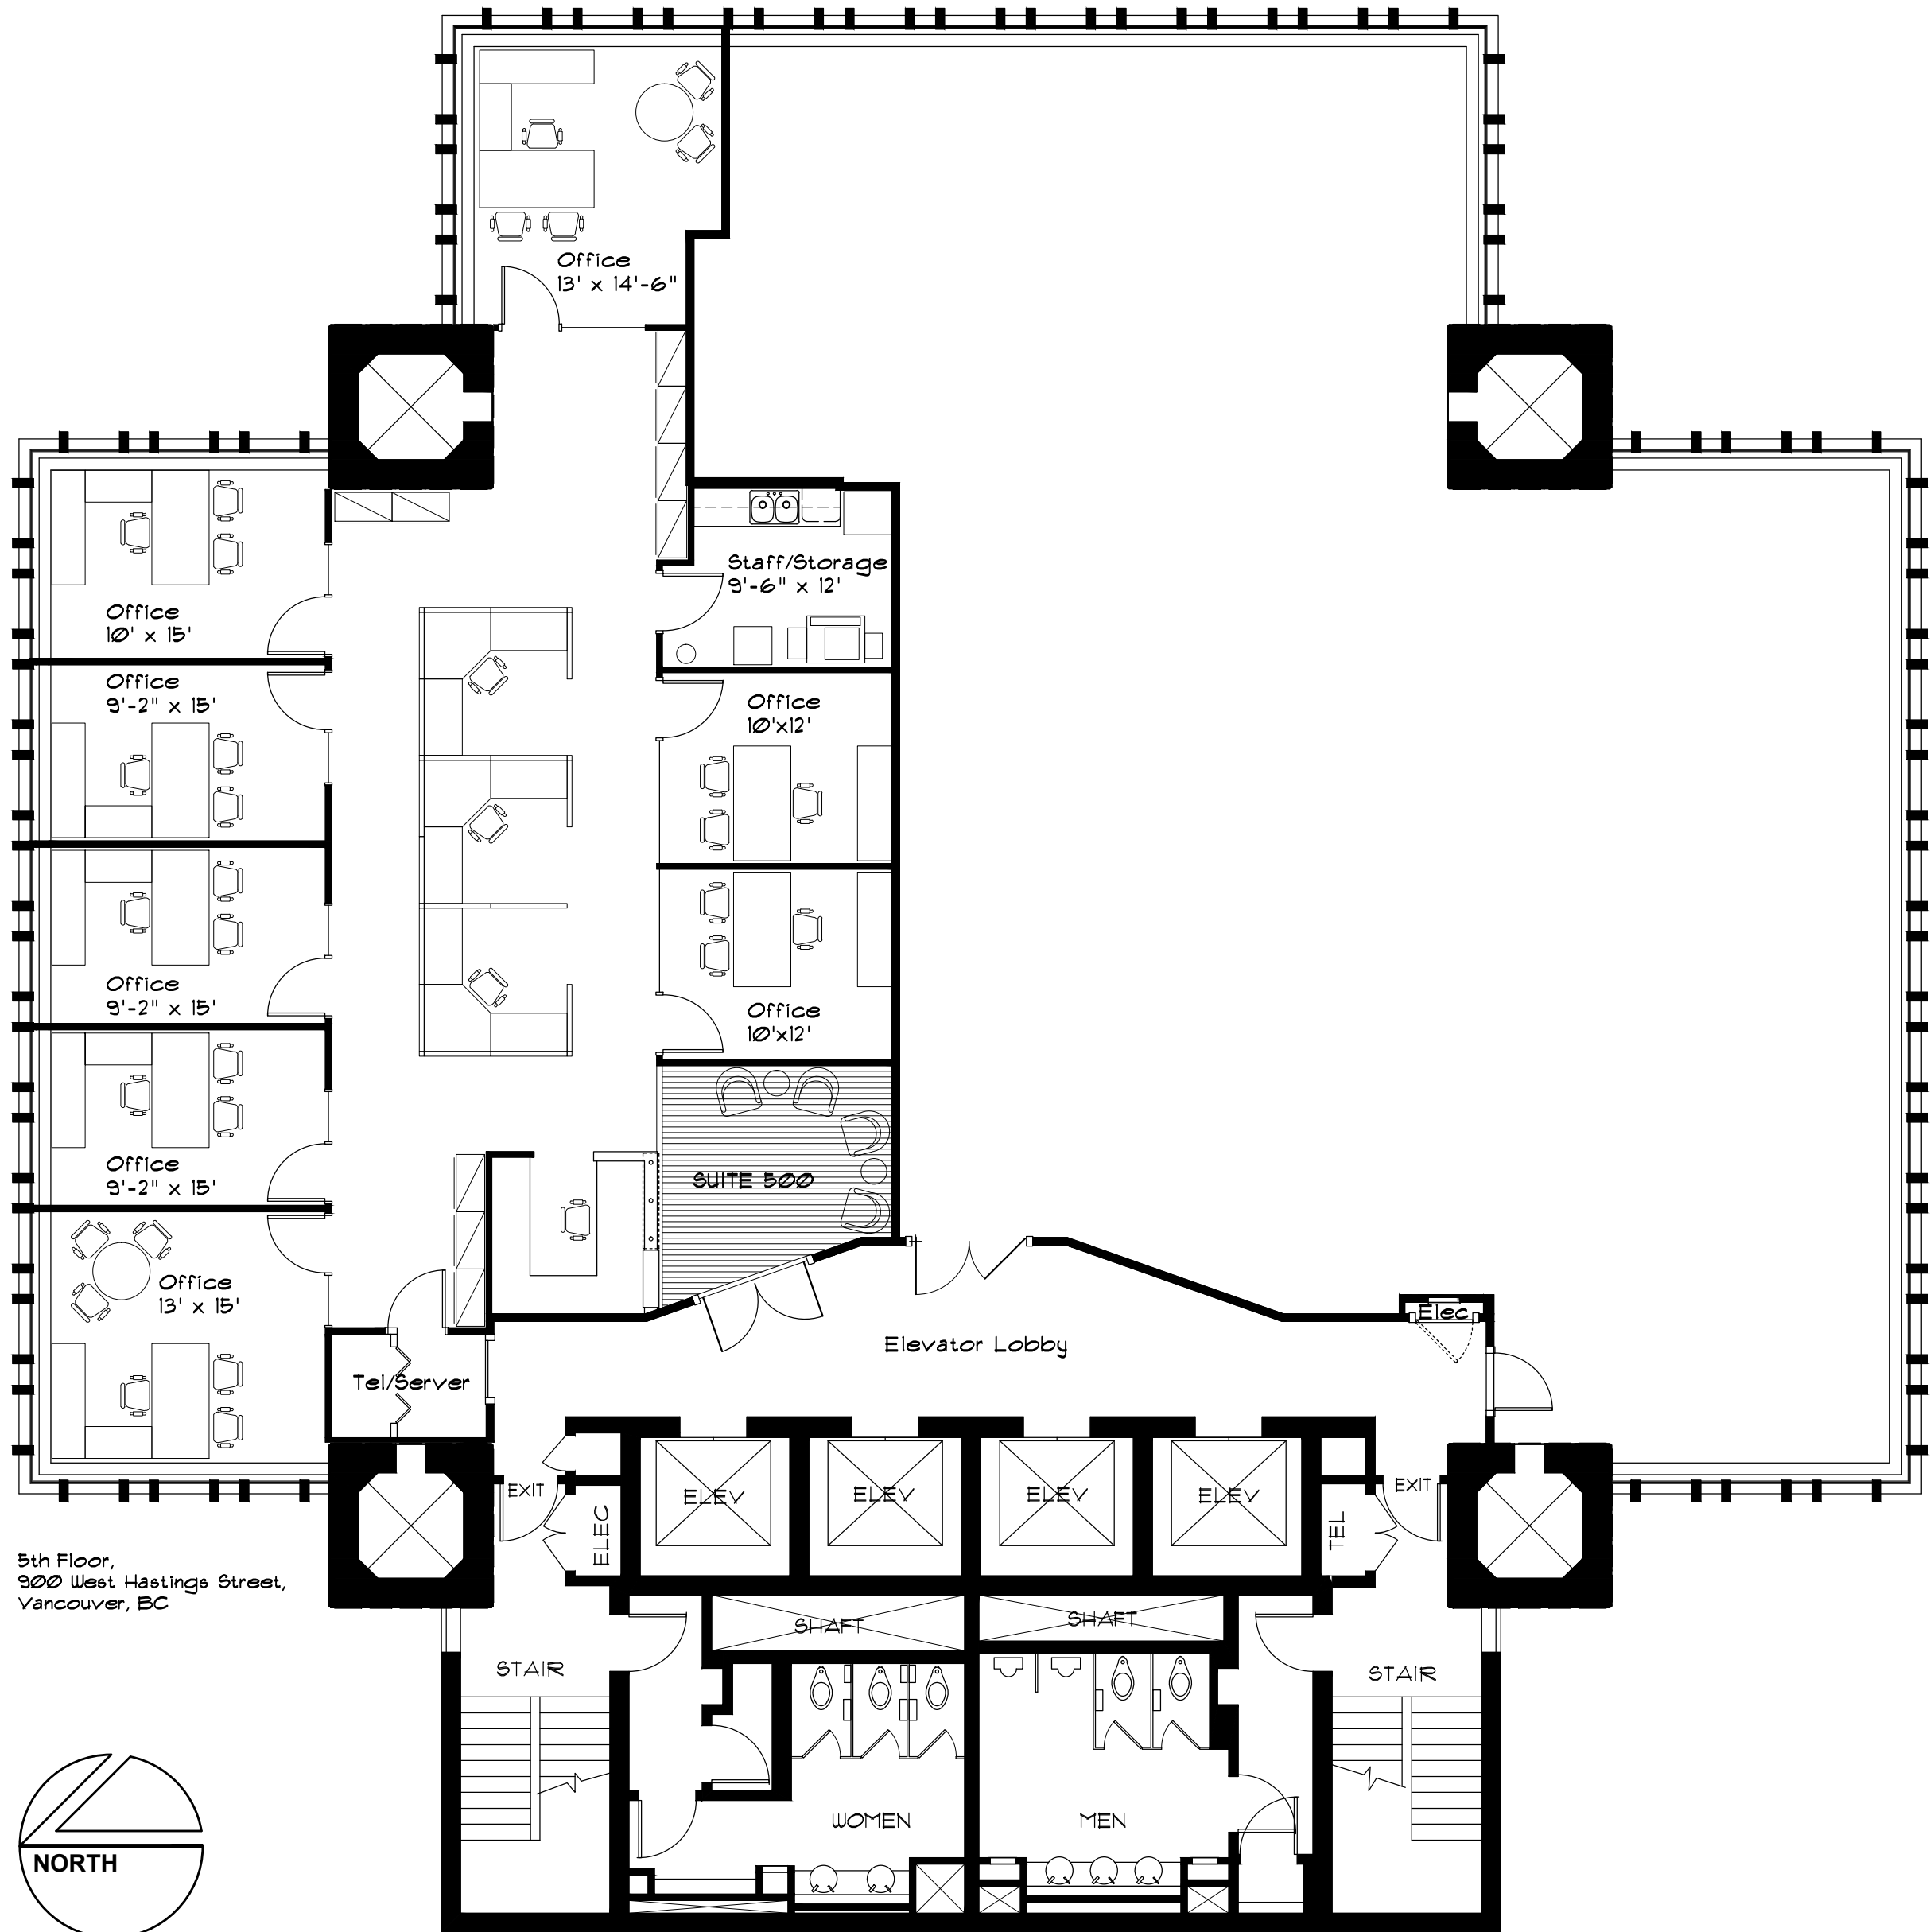

5th Floor,
900 West Hastings Street,
Vancouver, BC

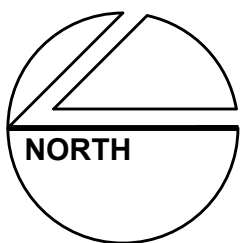

LANE